USA
FUJI-MARU
GENERAL ARRANGEMENT

SCALE 1:200

PRINCIPAL DIME

LENGTH	P.P.
BREADTH	Mld
DEPTH	Mld

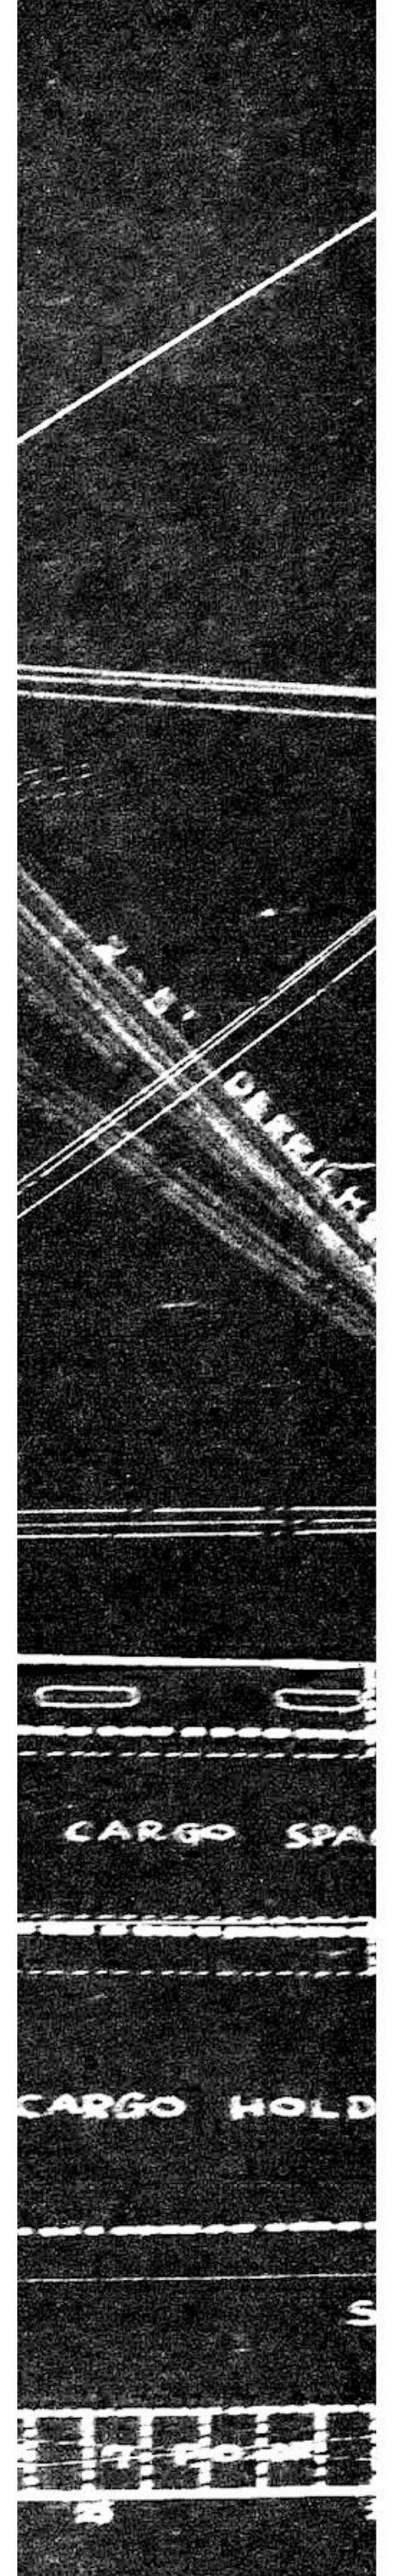
CARGO SPA
CARGO HOLD

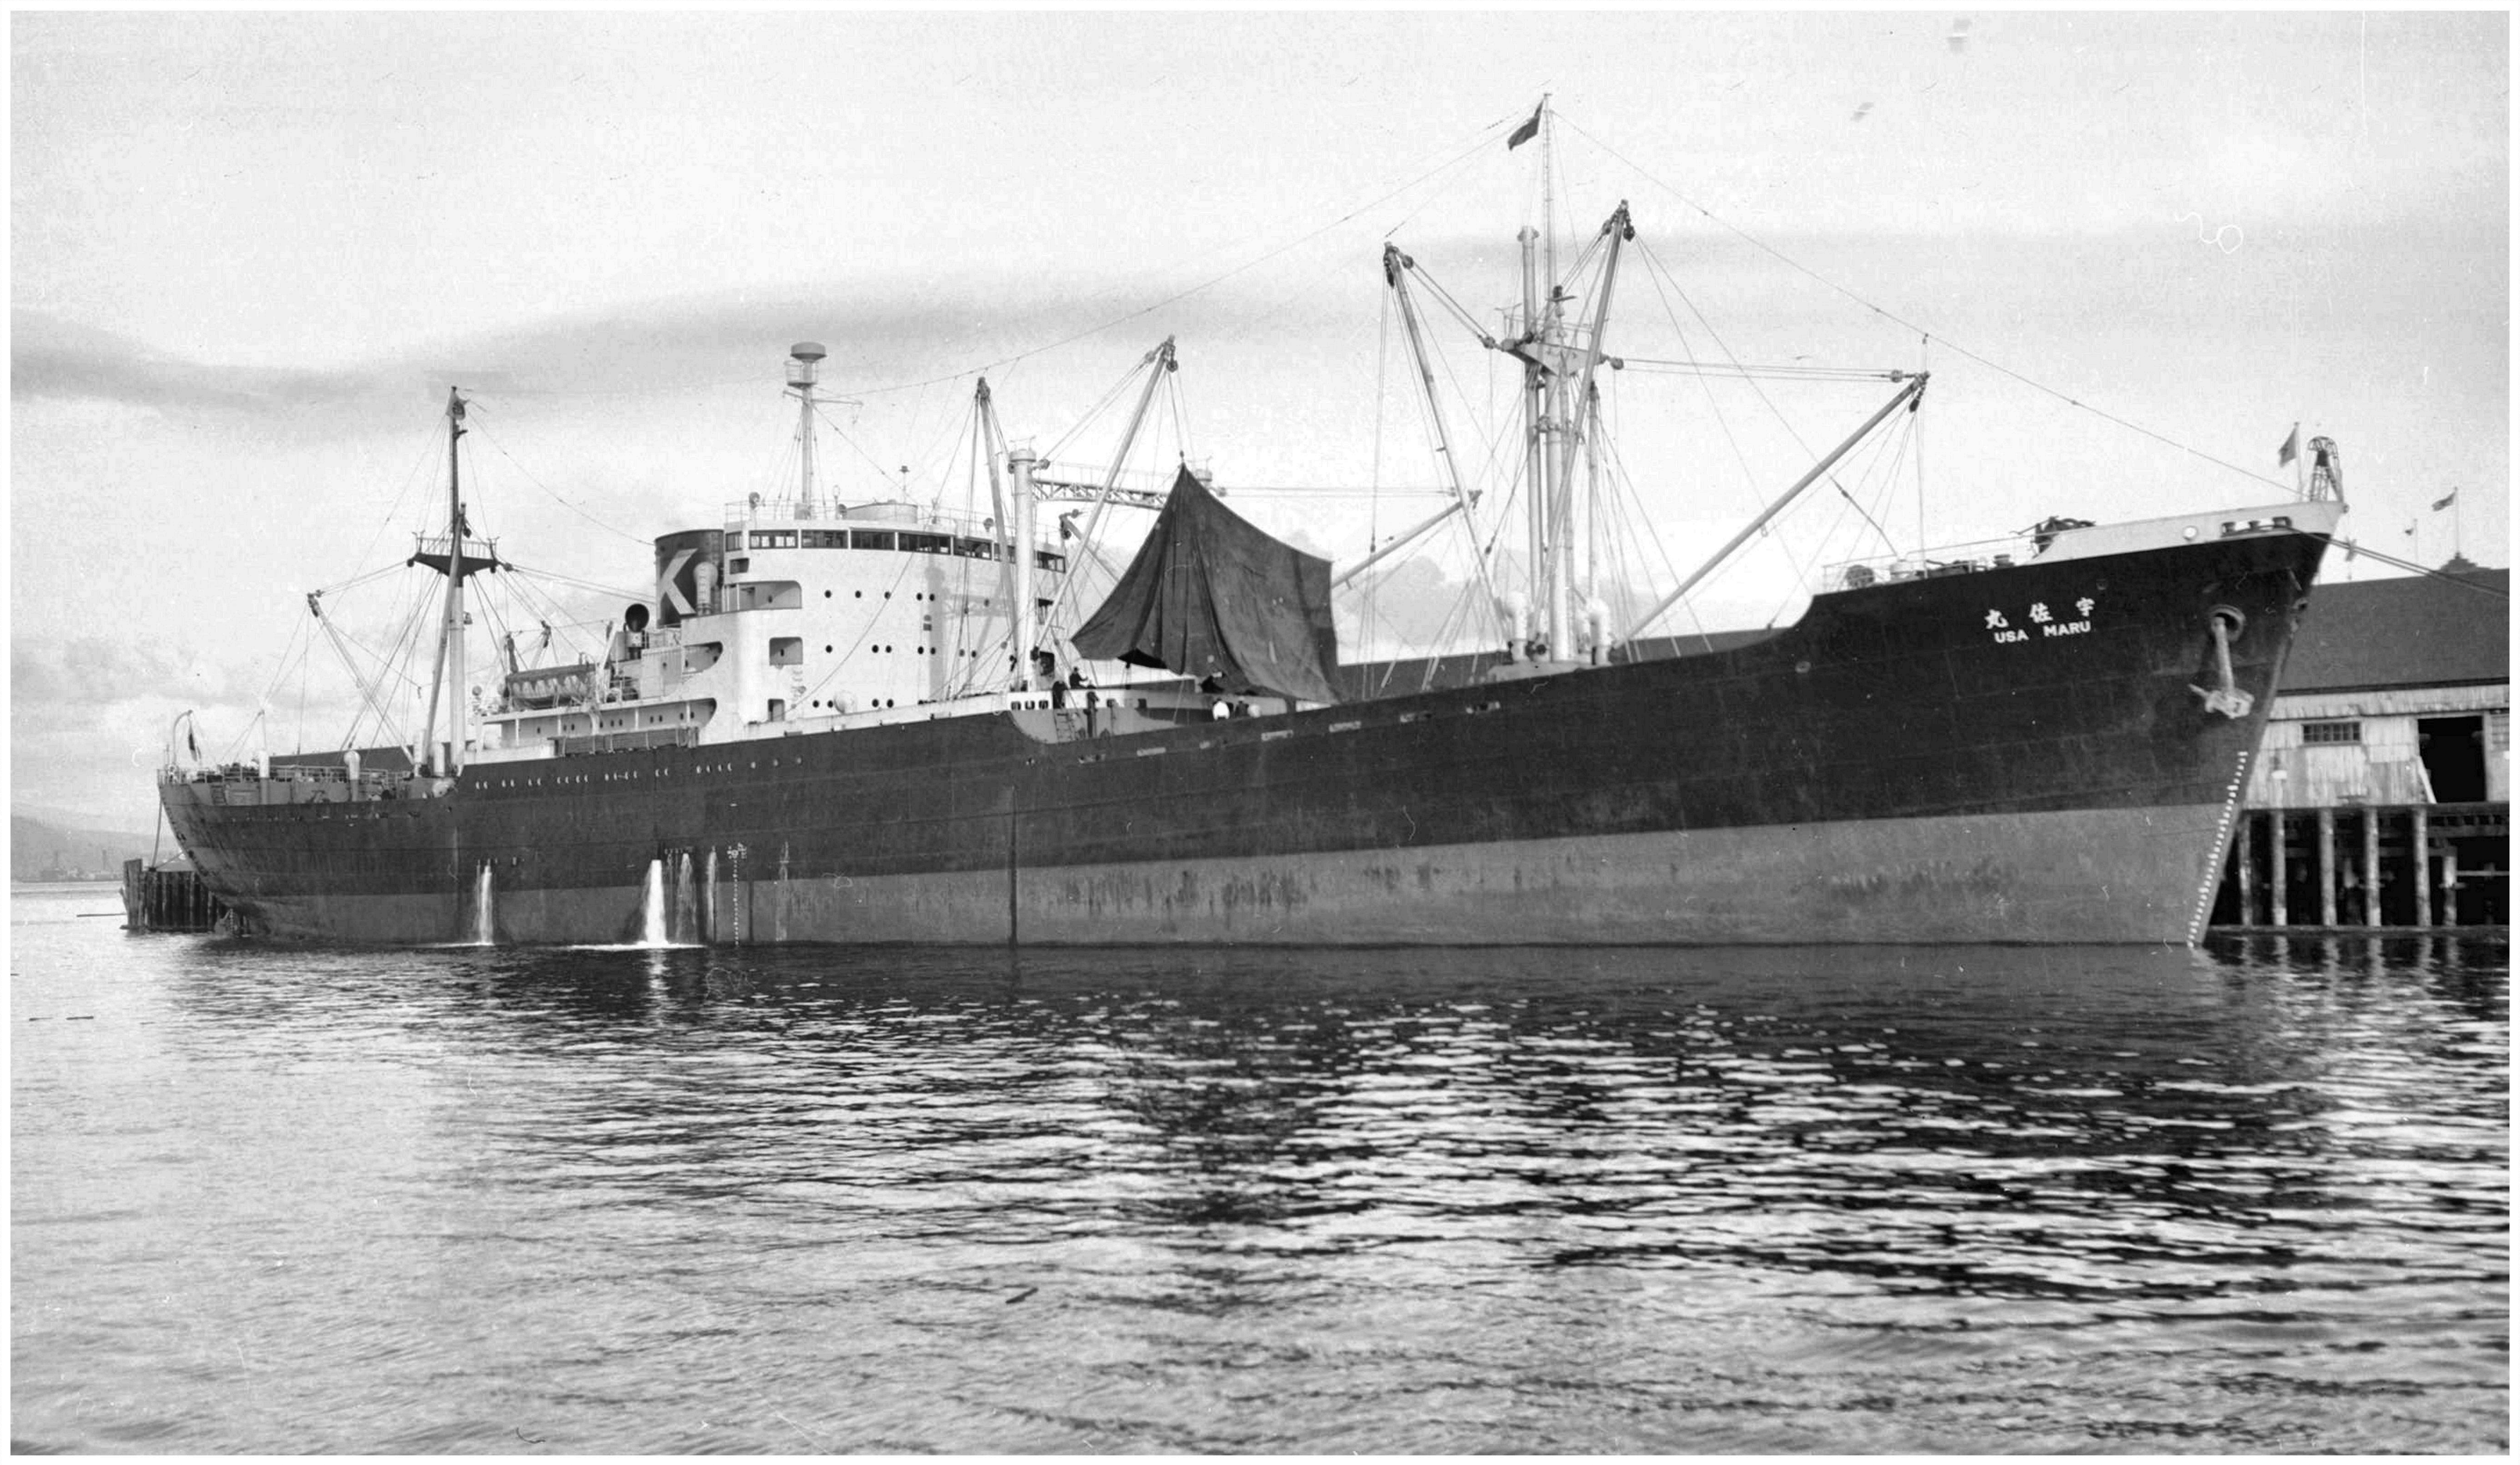
宇佐丸
USA MARU

ENG. OFFICE
OFF. & ENG. MESS ROOM
PANTRY
W.C.
BATH
MACHINERY OPENING
SMOKING ROOM
DINING SALOON
No 3 CARGO HATCH

COPY FOR
LONDON OFFICE

RECORDS DEPT.
LONDON

1

Usa Maru
Gen arrgt (as built)

Yka FE Rpt no. 665

© 2021
Lloyd's Register
Foundation

013115-013124-0138

~~FUJI~~ USA-MARU
GENERAL ARRANGEMENT
SCALE 1:200

PRINCIPAL DIMENSIONS		
LENGTH	P.P.	128ᵐ000
BREADTH	MLD	17ᵐ800
DEPTH	MLD	10ᵐ000

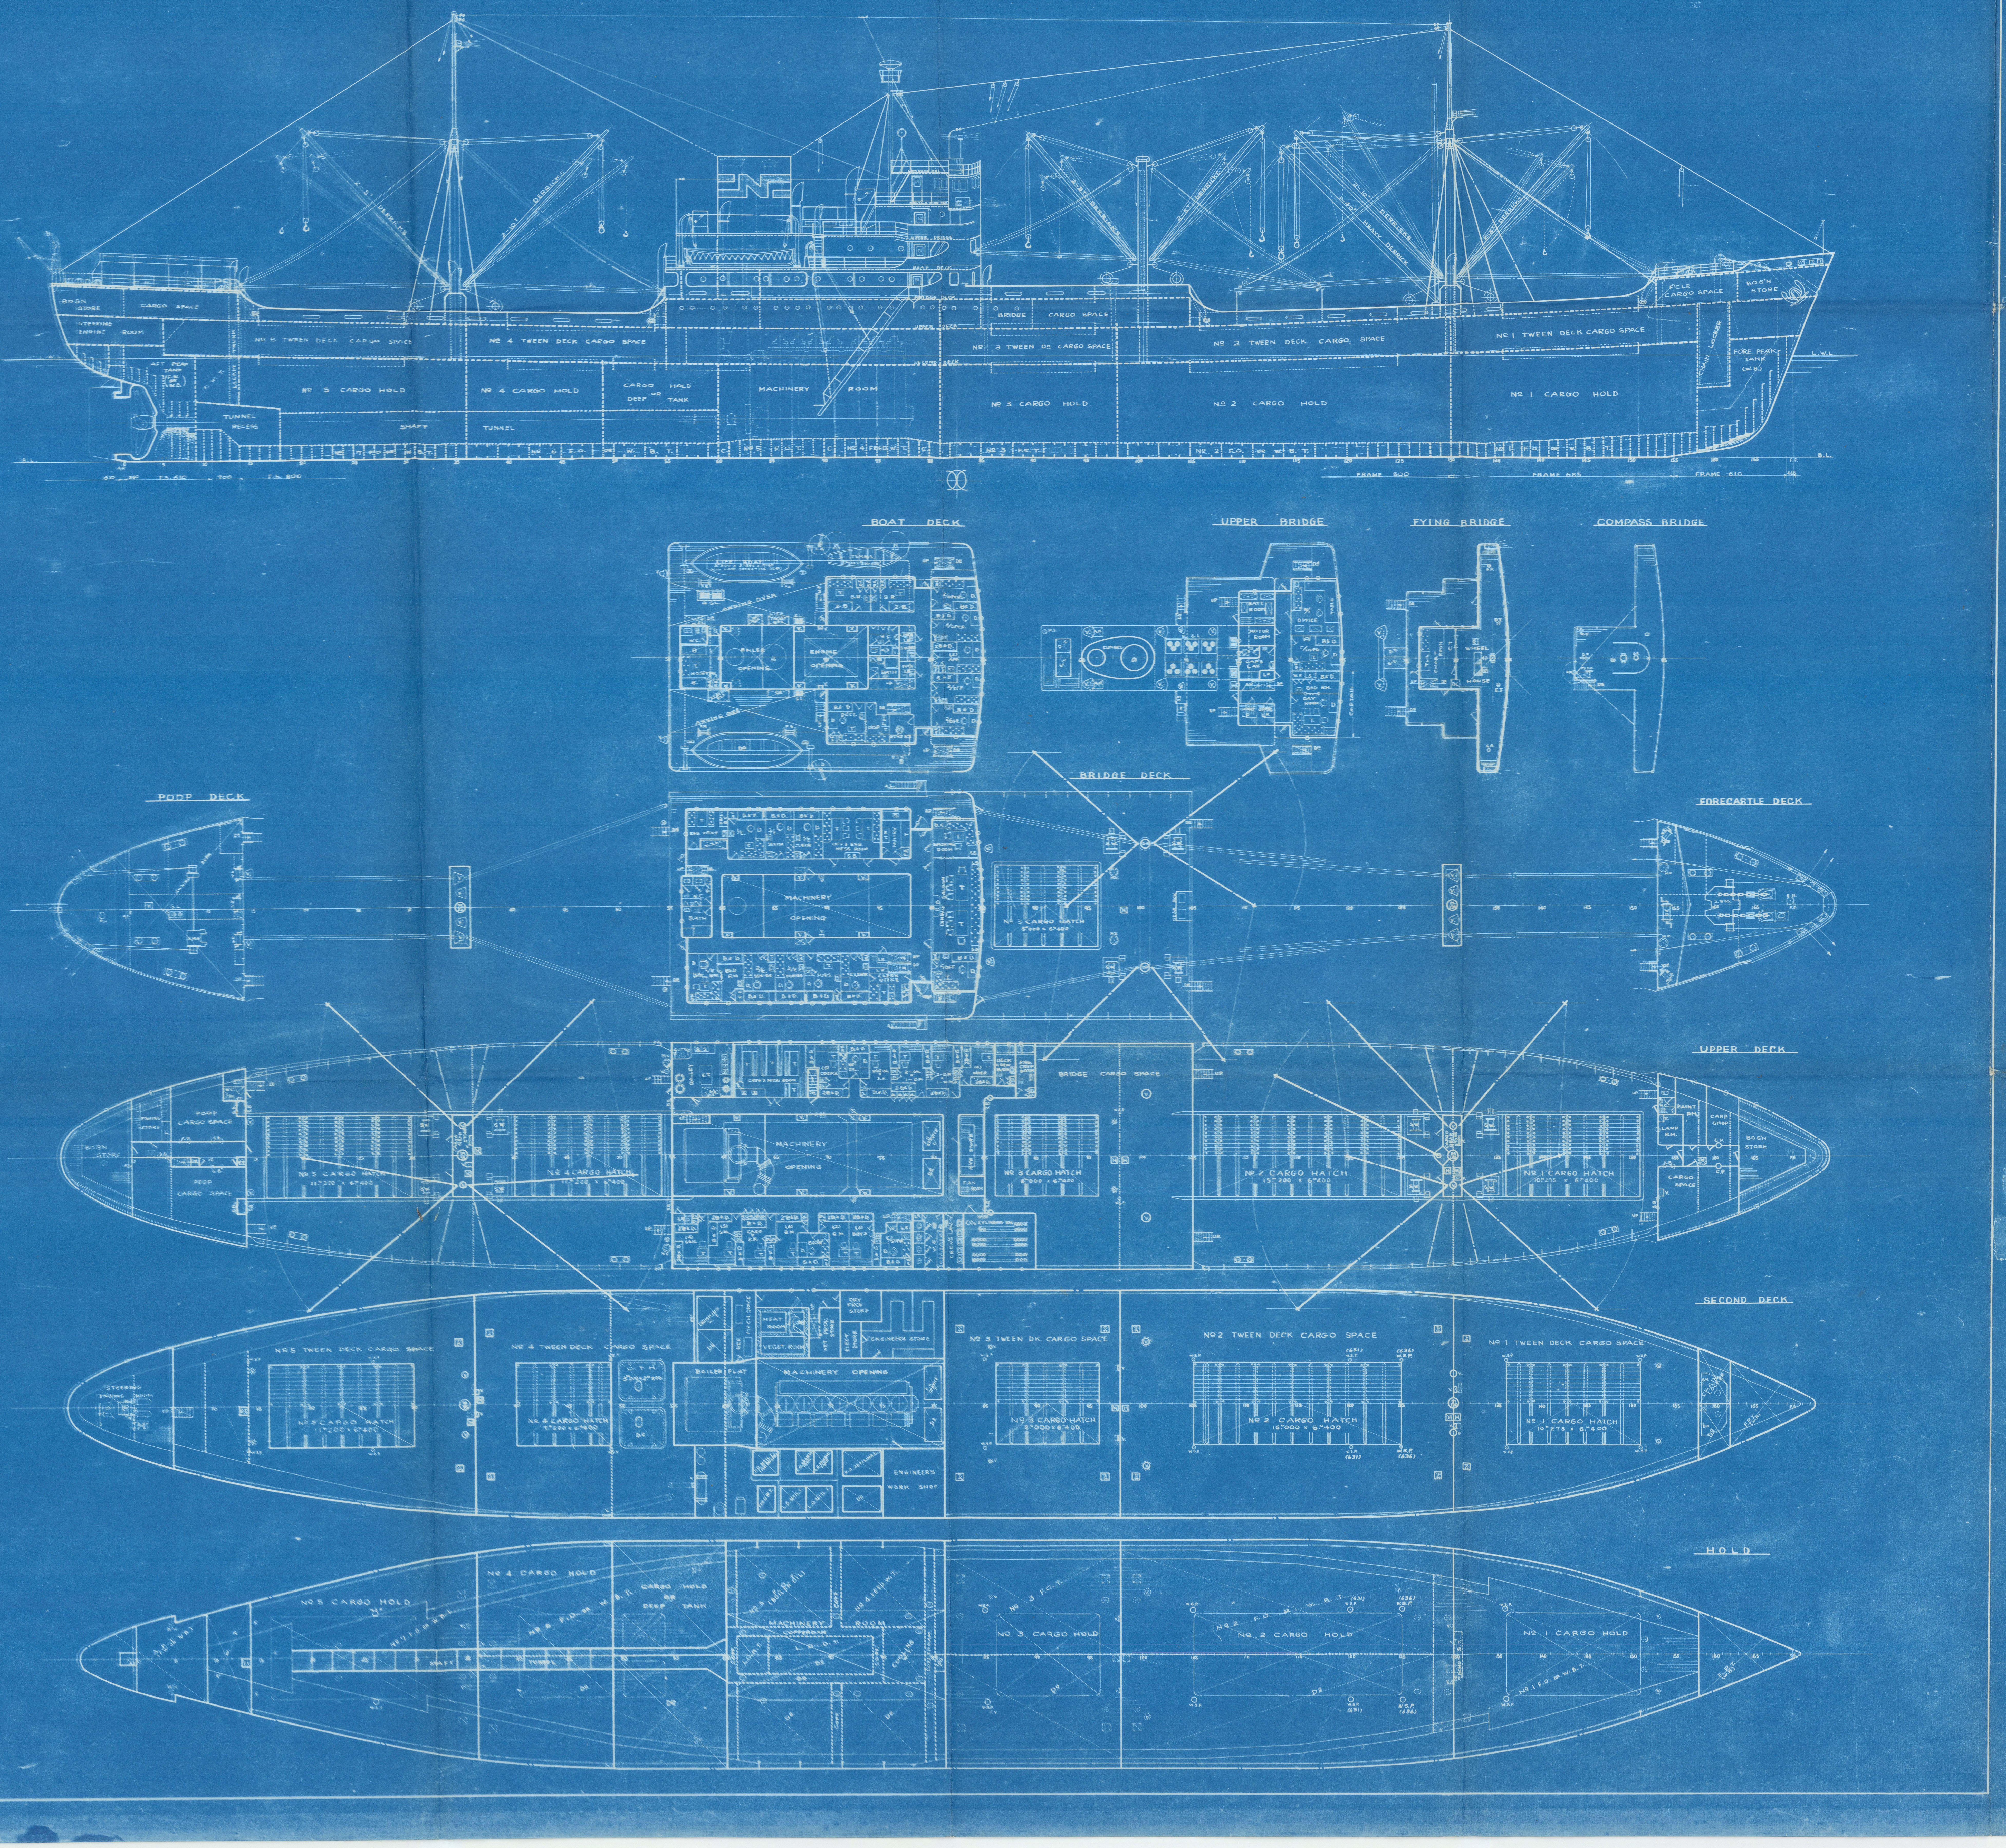

BOAT DECK
UPPER BRIDGE
FYING BRIDGE
COMPASS BRIDGE
POOP DECK
BRIDGE DECK
FORECASTLE DECK
UPPER DECK
SECOND DECK
HOLD
No 5 TWEEN DECK CARGO SPACE
No 4 TWEEN DECK CARGO SPACE
No 3 TWEEN DK CARGO SPACE
No 2 TWEEN DECK CARGO SPACE
No 1 TWEEN DECK CARGO SPACE
No 5 CARGO HOLD
No 4 CARGO HOLD
No 3 CARGO HOLD
No 2 CARGO HOLD
No 1 CARGO HOLD
MACHINERY ROOM
MACHINERY OPENING
BRIDGE CARGO SPACE
SHAFT TUNNEL
No 5 CARGO HATCH
No 4 CARGO HATCH
No 3 CARGO HATCH
No 2 CARGO HATCH
No 1 CARGO HATCH

No 631

宇佐丸

"As built"

GENERAL ARRANGEMENT

"USA MARU"

一般配置

完成圖

SCALE	1 : 200

浦賀船渠株式会社
URAGA SHIPYARD
URAGA DOCK CO. LTD
DESIGNING DEPT
浦賀造船所 設計部

27.5.12

27.5.10

類別番號	完成 一17.

©2021 Lloyd's Register Foundation